


Mozilla
650 Castro Street
Suite 400
Mountain View, CA 94041

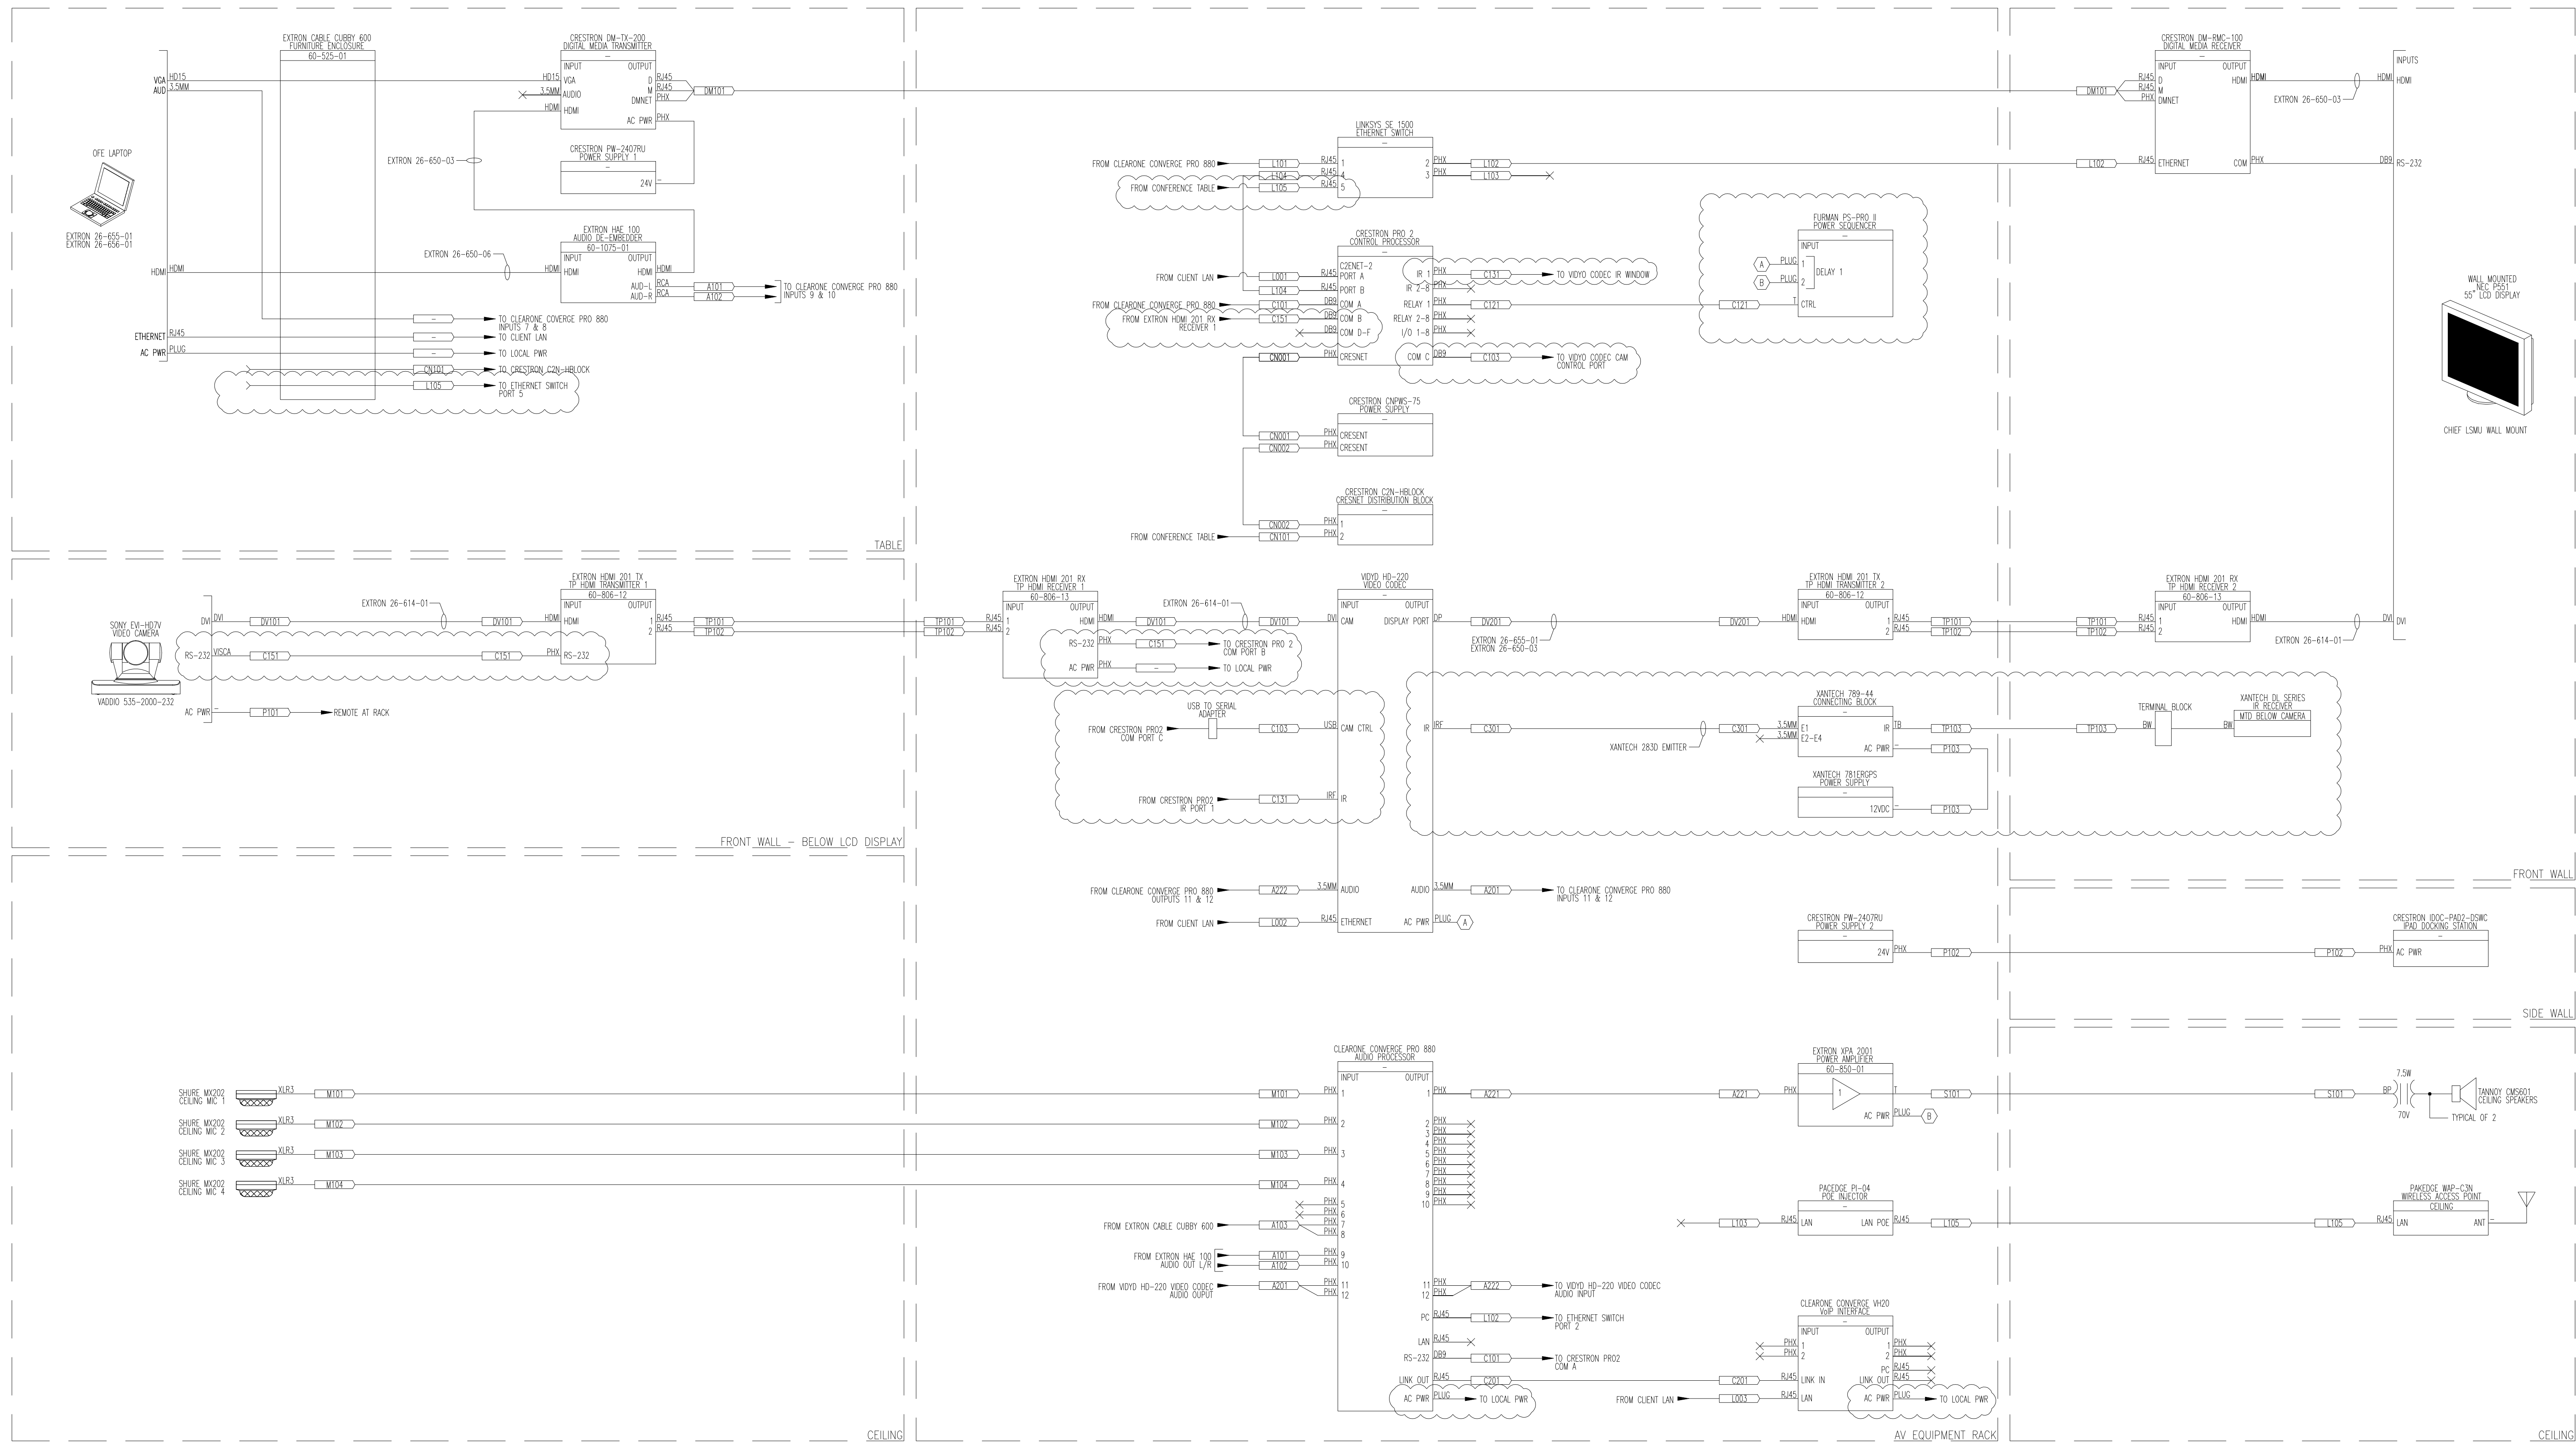

- PRELIMINARY
- For SUBMITTAL (CD1)
- For CONSTRUCTION (CD2)
- AS BUILTS
- SKETCH
- Other

1 11-07-11 Revision 3

No	Date	Description

Notice:
This drawing is the property of Avidex. Design information, drawings, details, and/or specification data may not be reproduced or duplicated. No work may be executed without written authorization of Avidex.
© Copyright 2004, Avidex Industries LLC

Job Number: 110123
Engineered By: B. MacLeod
Project Manager:
Drawn By: B. MacLeod
Approved By:
Scale: AS NOTED
File Name:

AV System Plan for:
Mozilla
650 Castro Street, Suite 400
Mountain View, CA 94041

SHEET TITLE
AV FUNCTIONAL
KUNG-FU CONFERENCE ROOM

DWG NUMBER

AVF-1.02