


**Mozilla**  
650 Castro Street, Suite 300  
Mountain View, CA 94041-2021

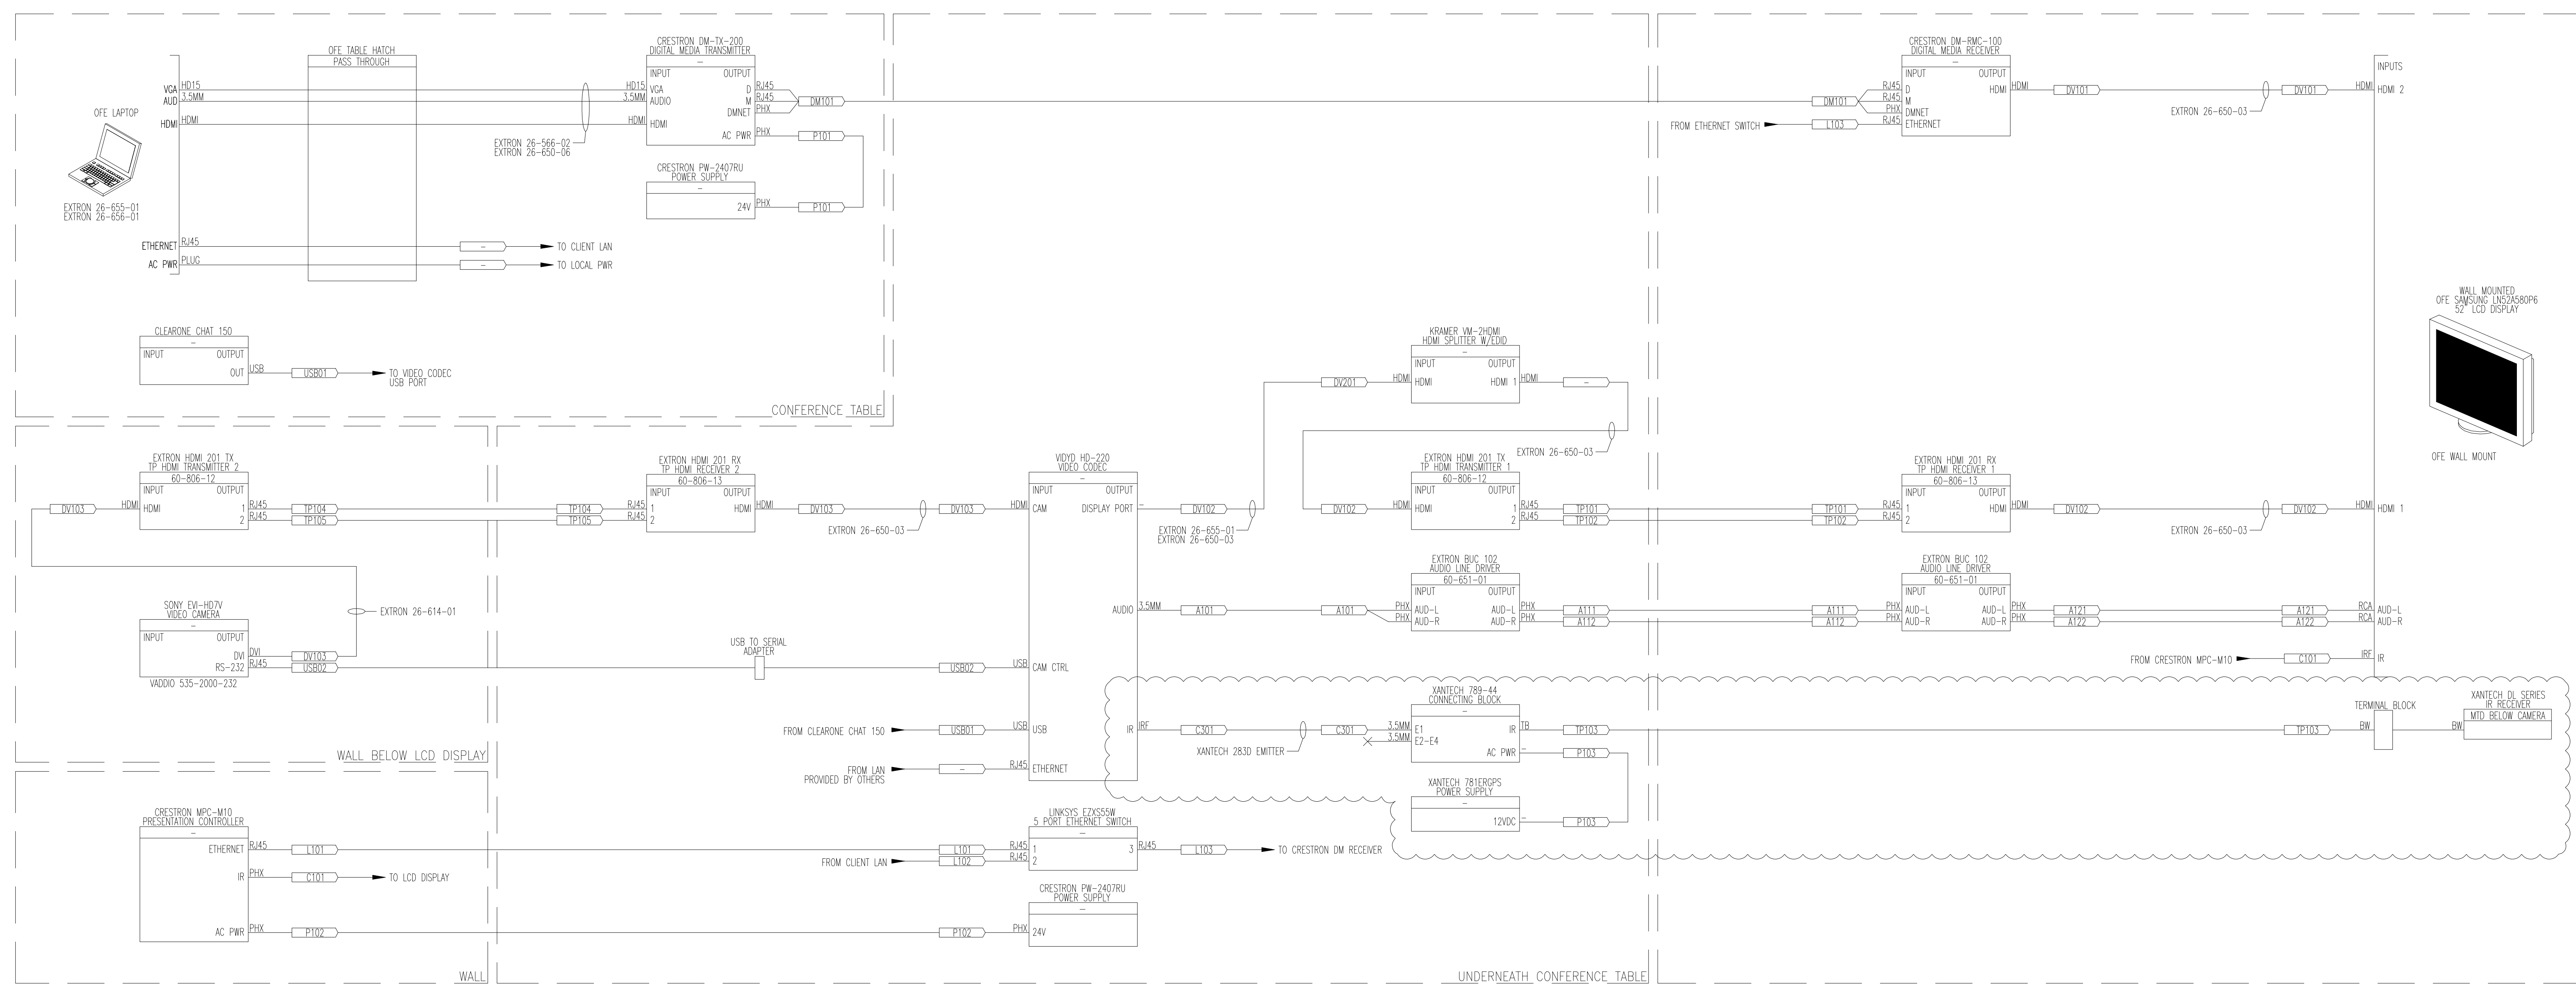

- PRELIMINARY
- For SUBMITTAL (CD1)
- For CONSTRUCTION (GD2)
- AS BUILTS
- SKETCH
- Other

No	Date	Description
2	11-07-11	Revision 1
1	05-18-11	For Construction

**Notice:**  
This drawing is the property of Avidex. Design information, drawings, details, and/or specification data may not be reproduced or duplicated. No work may be executed without written authorization of Avidex.  
© Copyright 2004, Avidex Industries LLC

Job Number: 110283  
Engineered By: B. MacLeod  
Project Manager: B. MacLeod  
Drawn By: B. MacLeod  
Approved By:  
Scale: AS NOTED  
File Name:

AV System Plan for:  
**Mozilla**  
650 Castro Street, Suite 300  
Mountain View, CA 94041-2021

SHEET TITLE  
**AV FUNCTIONAL**  
G100

DWG NUMBER  
**AVF-1.00**