


Mozilla
650 Castro Street, Suite 300
Mountain View, CA 94041-2021

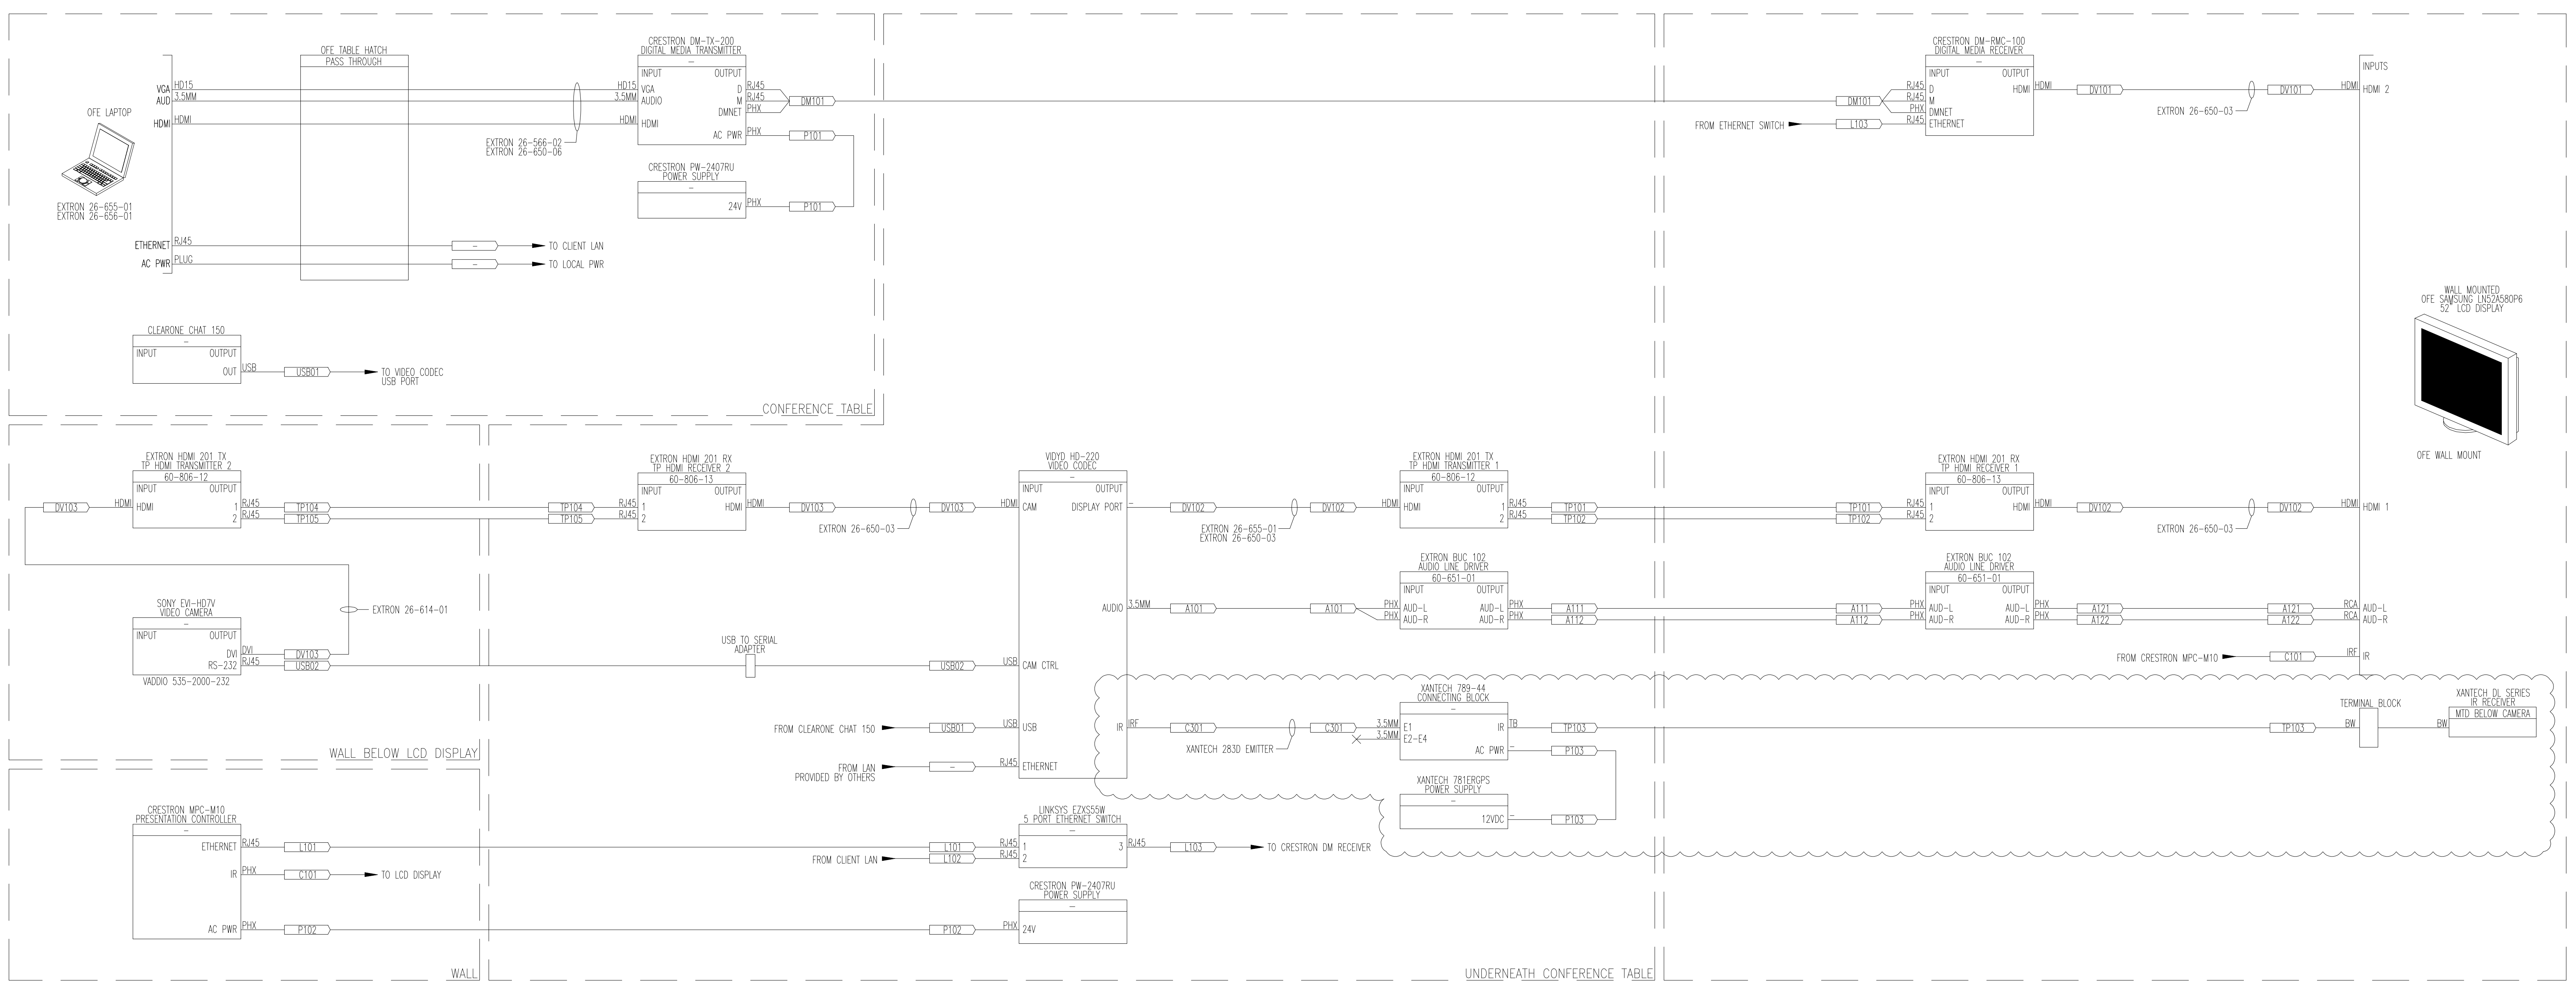

- PRELIMINARY
- For SUBMITTAL (CD1)
- For CONSTRUCTION (GD2)
- AS BUILTS
- SKETCH
- Other

No	Date	Description
3	11-07-11	Revision 1
2	05-18-11	AS Built Drawings
1	04-19-11	For Construction

Notice:
This drawing is the property of Avidex. Design information, drawings, details, and/or specification data may not be reproduced or duplicated. No work may be executed without written authorization of Avidex.
© Copyright 2004, Avidex Industries LLC

Job Number: 110178
Engineered By: B. MacLeod
Project Manager: B. MacLeod
Drawn By: B. MacLeod
Approved By:
Scale: AS NOTED
File Name:

AV System Plan for:
Mozilla
650 Castro Street, Suite 300
Mountain View, CA 94041-2021

SHEET TITLE
AV FUNCTIONAL
3RD FLOOR - ALL YOUR BASE & PB & J

DWG NUMBER
AVF-1.00