


**Mozilla**  
650 Castro Street  
Suite 400  
Mountain View, CA 94041

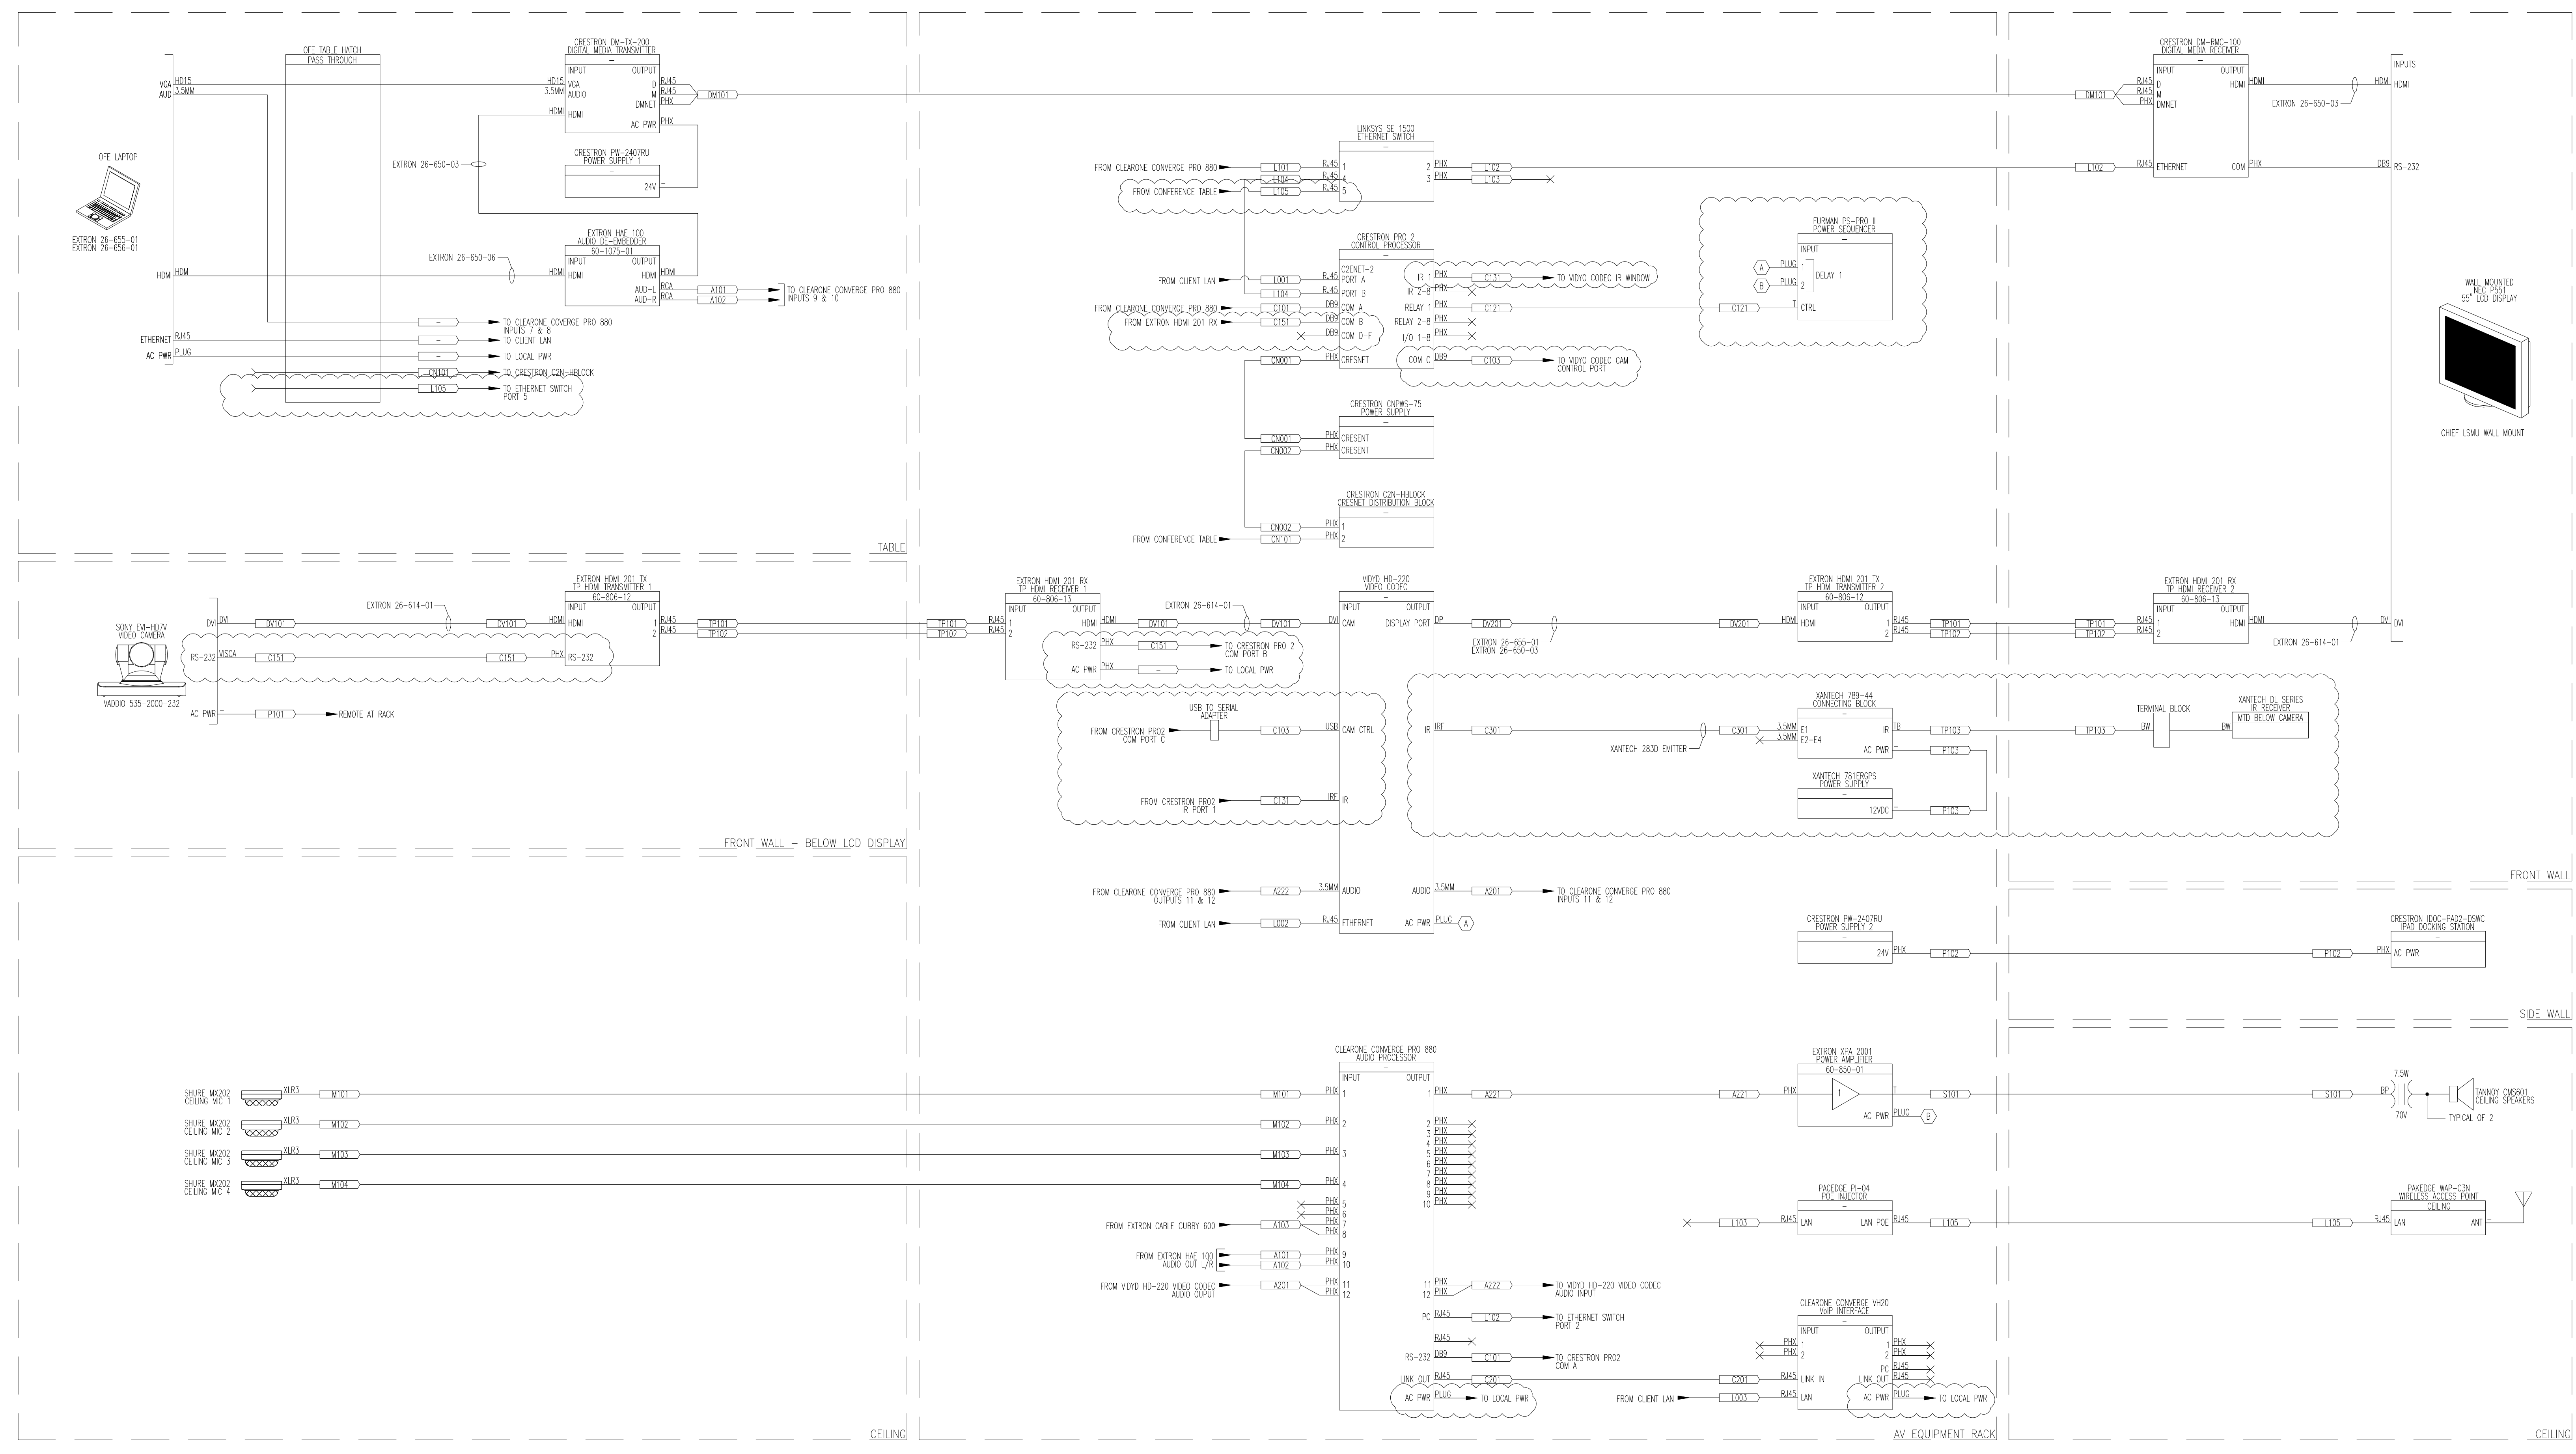

- PRELIMINARY
- For SUBMITTAL (CD1)
- For CONSTRUCTION (CD2)
- AS BUILTS
- SKETCH
- Other:

No	Date	Description
1	11-07-11	Revision 3

**Revisions**

**Notice:**  
This drawing is the property of Avidex. Design information, drawings, details, and/or specification data may not be reproduced or duplicated. No work may be executed without written authorization of Avidex.  
© Copyright 2004, Avidex Industries LLC

**Job Number:** 110123  
**Engineered By:** B. MacLeod  
**Project Manager:**  
**Drawn By:** B. MacLeod  
**Approved By:**  
**Scale:** AS NOTED  
**File Name:**

**AV System Plan for:**  
**Mozilla**  
650 Castro Street, Suite 400  
Mountain View, CA 94041

**SHEET TITLE**  
AV FUNCTIONAL  
MICHAEL BOLTON CONFERENCE ROOM

**DWG NUMBER**  
AVF-1.03