


Mozilla
2 HARRISON STREET
7TH FLOOR
SAN FRANCISCO, CA 94105

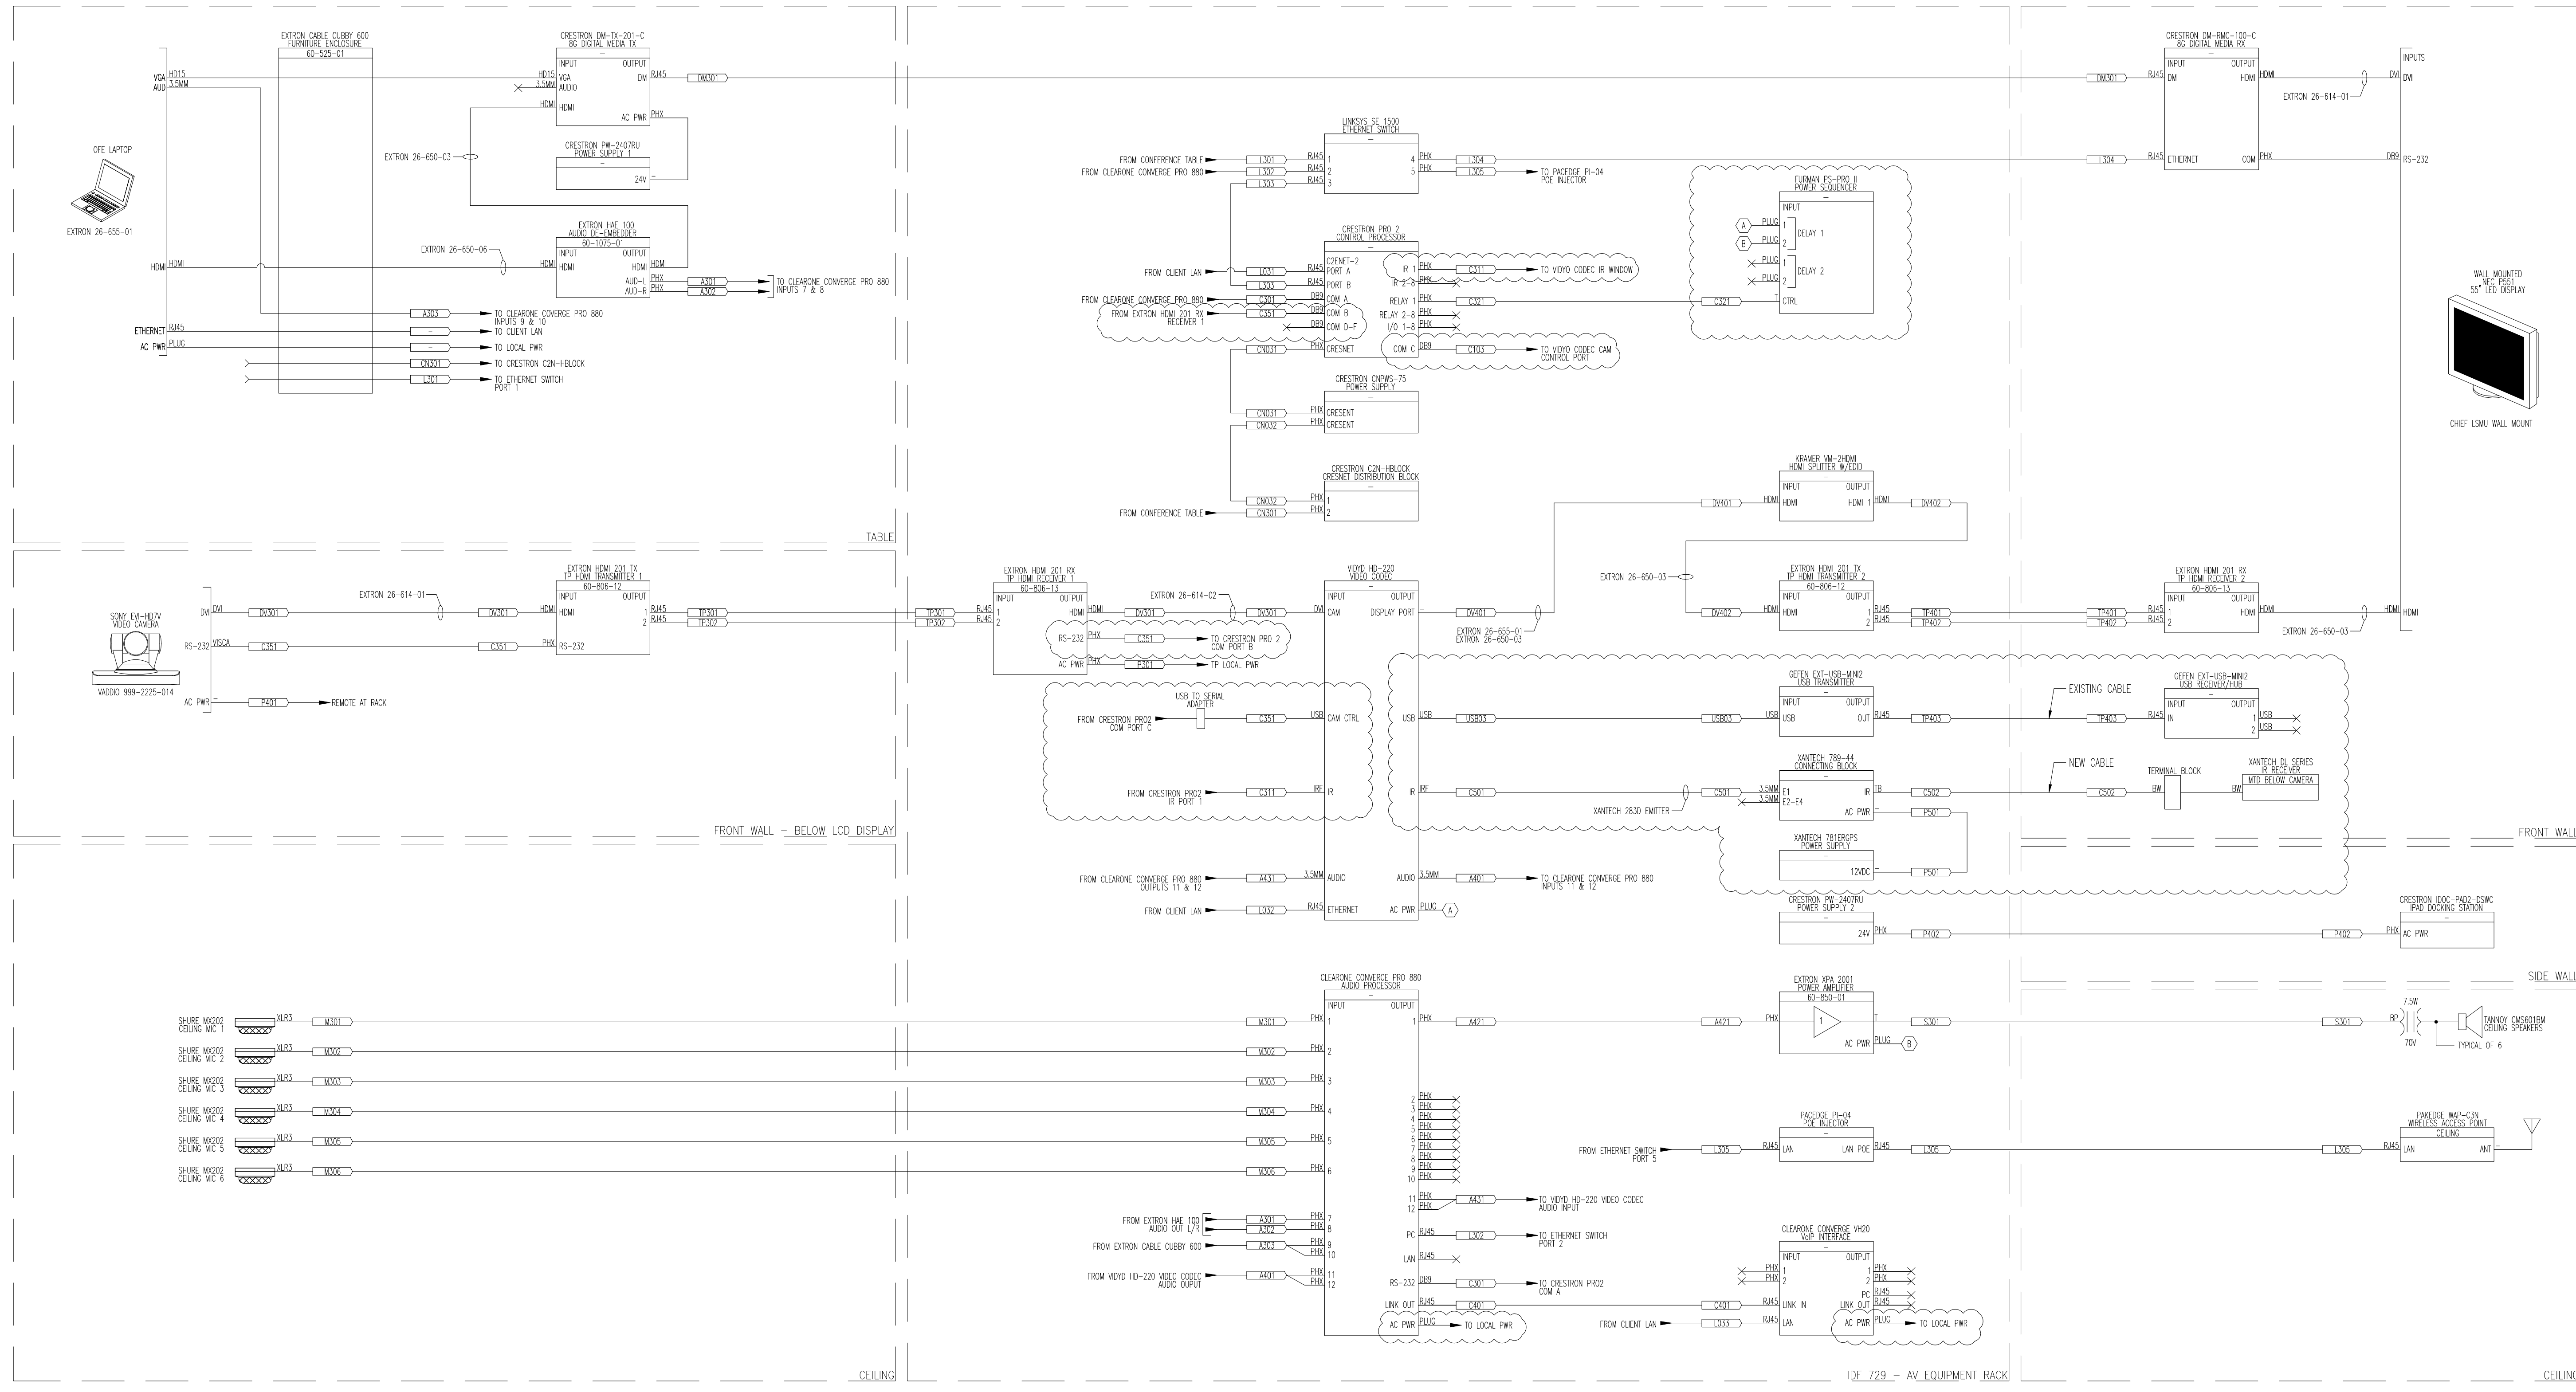

- PRELIMINARY
- For SUBMITTAL (CD1)
- AS BUILTS
- SKETCH
- Other

No	Date	Description
4	11-09-11	Update 2
3	7-25-11	Update 1
2	7-11-11	Issued For Construction
1	6-22-11	Issued For Coordination

Revisions

Notice:
This drawing is the property of Avidex. Design information, drawings, details, and/or specification data may not be reproduced or duplicated. No work may be executed without written authorization of Avidex.
© Copyright 2004, Avidex Industries LLC

Job Number: 110326
Engineered By: B. MacLeod
Project Manager:
Drawn By: B. MacLeod
Approved By:
Scale: AS NOTED
File Name:

AV System Plan for:
Mozilla
2 HARRISON STREET, 7TH FLOOR
SAN FRANCISCO, CA 94105

SHEET TITLE
AV FUNCTIONAL
CONFERENCE ROOM 750

DWG NUMBER
AVF-1.03