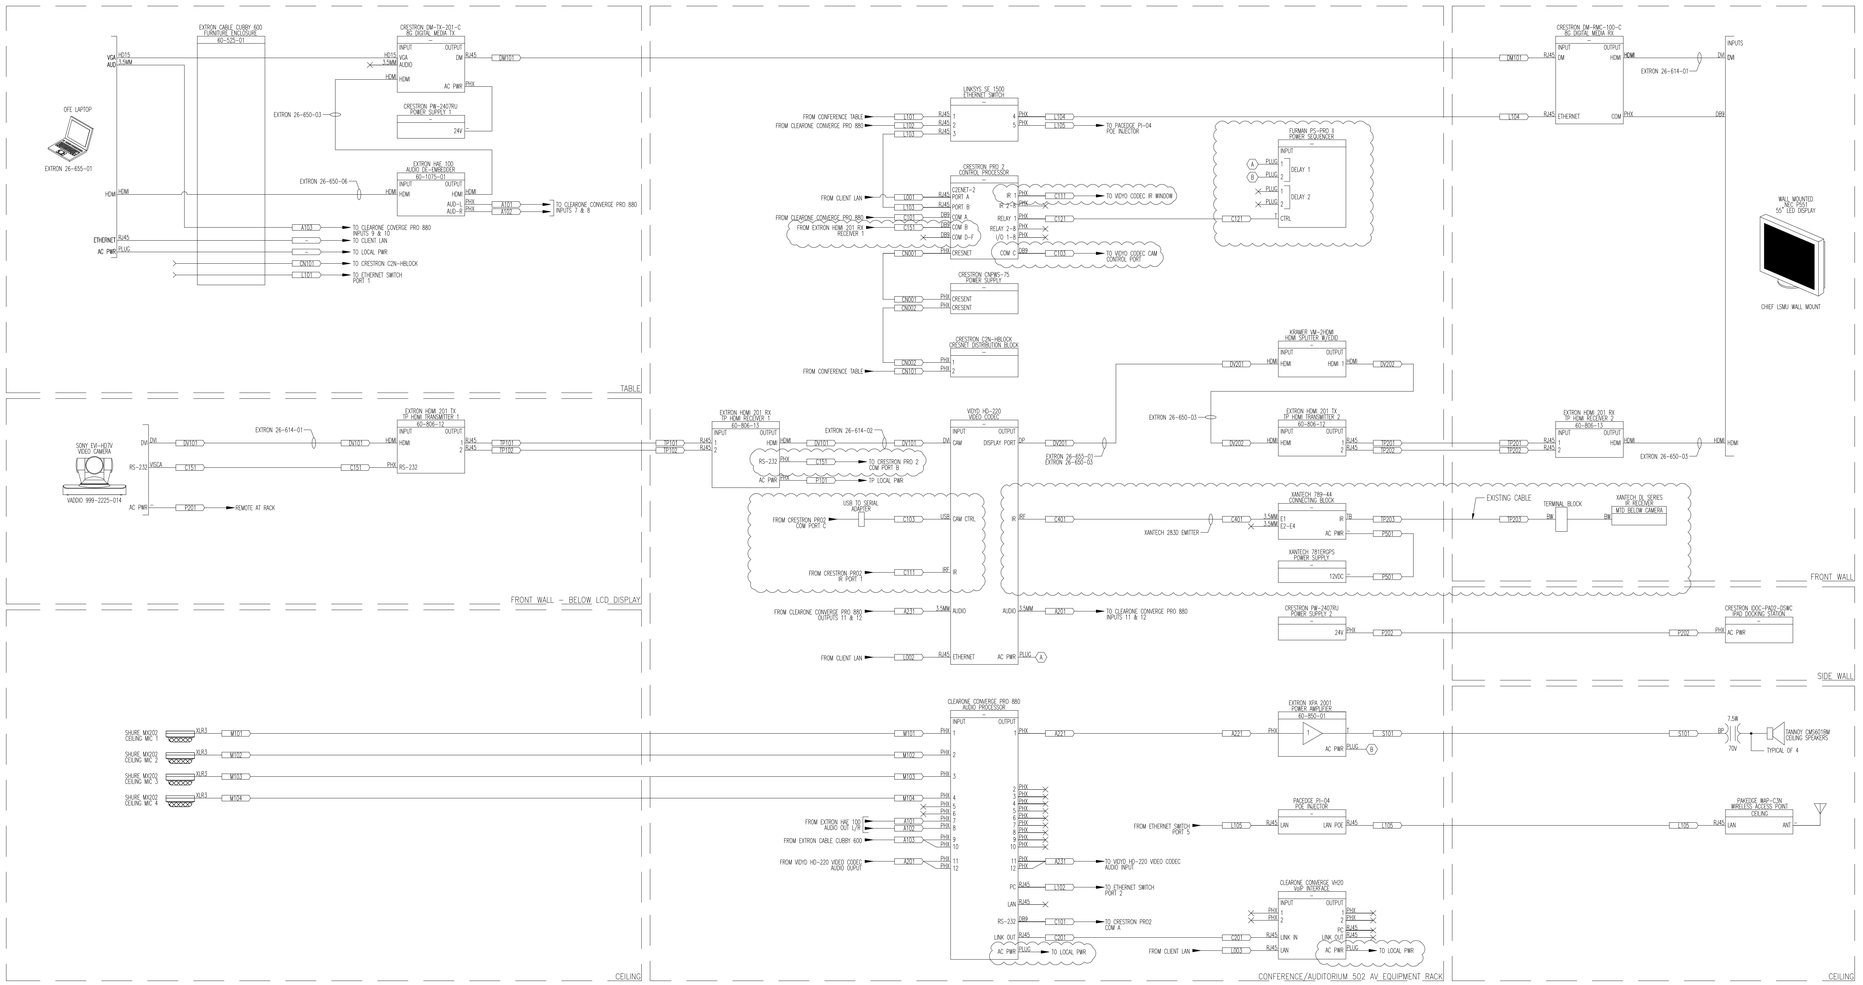

avidex
6100 Stewart Avenue
Fremont, California 94538
Phone: 800-999-8590 Fax: 510-279-7101
www.avidexav.com

A/V System Designed & Engineered For:

Mozilla
2 HARRISON STREET
7TH FLOOR
SAN FRANCISCO, CA 94105

- ☐ PRELIMINARY
- ☐ For SUBMITTAL (CD1)
- ■ For CONSTRUCTION (CD2)
- ☐ AS BUILTS
- ☐ SKETCH
- ☐ Other: _____

No	Date	Description
4	11-09-11	Update 2
3	7-25-11	Update 1
2	7-11-11	Issued For Construction
1	6-22-11	Issued For Coordination

Revisions

Notice:

This drawing is the property of Avidex. Design information, drawings, details, and / or specification data may not be reproduced or duplicated. No work may be executed without written authorization of Avidex.

© Copyright 2004, Avidex Industries LLC

Job Number :	110326
Engineered By :	B. Mac Leod
Project Manager :	
Drawn By :	B. Mac Leod
Approved By :	
Scale :	AS NOTED
File Name :	-

A/V System Plan for:

Mozilla
2 HARRISON STREET, 7TH FLOOR
SAN FRANCISCO, CA 94105

SHEET TITLE
AV FUNCTIONAL
CONFERENCE ROOM 704

DWG NUMBER

AVF-1.02