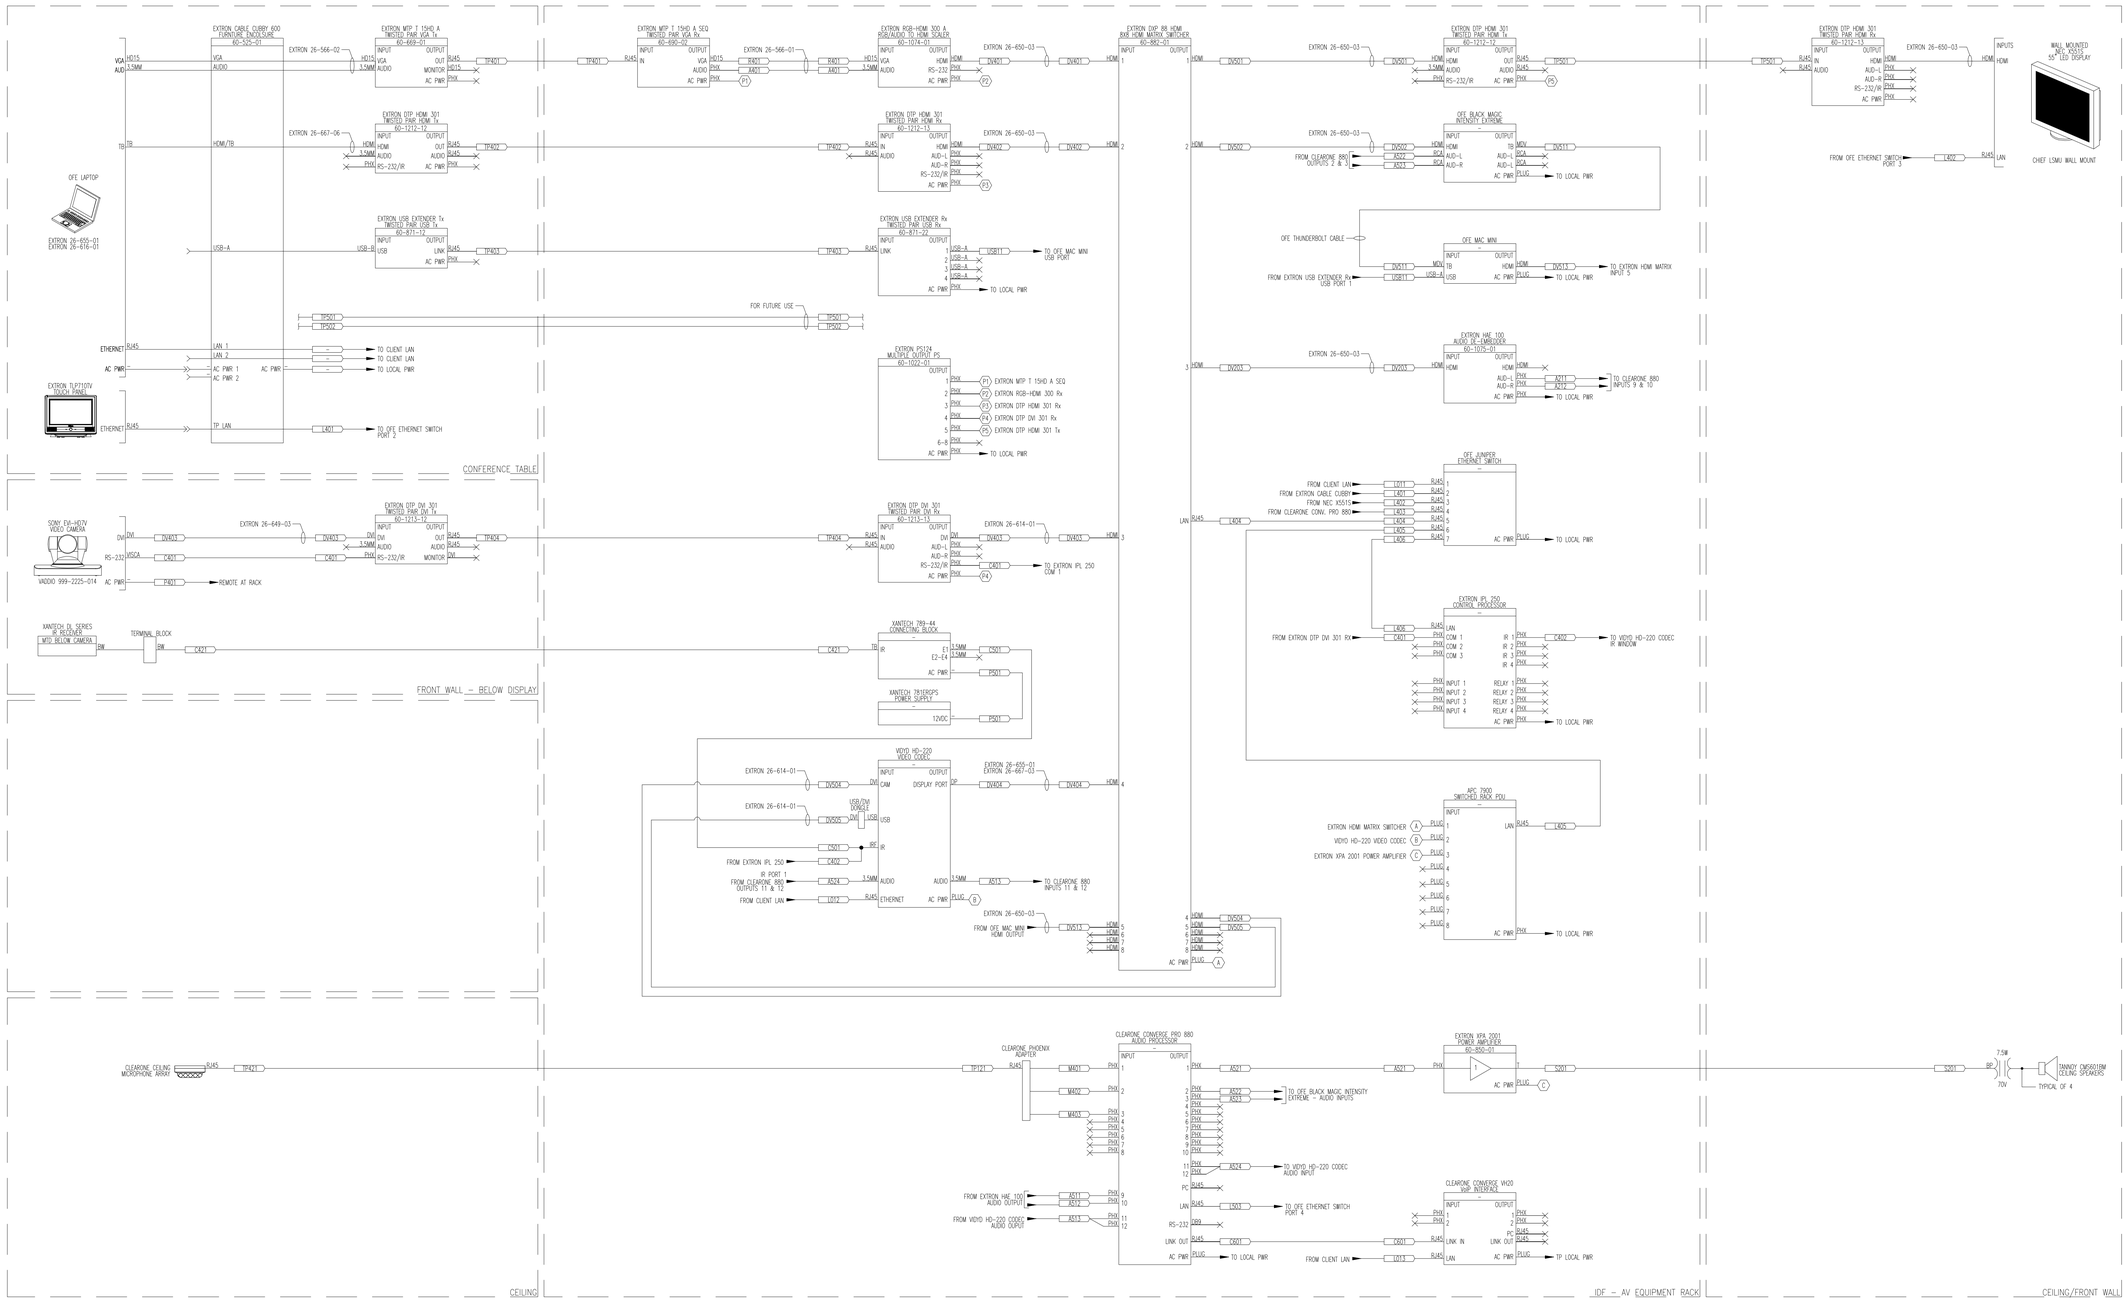

avidex
6100 Stewart Avenue
Fremont, California 94538
Phone: 800-999-8590 Fax: 510-279-7101
www.avidexav.com

A/V System Designed & Engineered For:

Mozilla San Francisco
2 Harrison Street, Suite 310
San Francisco, CA 94105

- ☐ PRELIMINARY
- ☐ For SUBMITTAL (CD1)
- ☐ For CONSTRUCTION (CD2)
- ■ AS BUILTS
- ☐ SKETCH
- ☐ Other: _____

No	Date	Description
4	6-27-12	As-Built
3	6-11-12	Revision 2
2	6-7-12	Revision 1
1	1-31-12	For Review

Revisions

Notice:
This drawing is the property of Avidex. Design information, drawings, details, and / or specification data may not be reproduced or duplicated. No work may be executed without written authorization of Avidex.
© Copyright 2004, Avidex Industries LLC

Job Number :	120344
Engineered By :	B. Mac Leod
Project Manager :	
Drawn By :	B. Mac Leod
Approved By :	
Scale :	As Noted
File Name :	--

A/V System Plan for:

Mozilla San Francisco
2 Harrison Street, Suite 310
San Francisco, CA 94105

SHEET TITLE
AV FUNCTIONAL
BAY BRIDGE CONF. RM. 329

DWG NUMBER
AVF-1.01